


N.M. CO. EAST 1/2, S. 2, T. 14 N., R. 14 W.

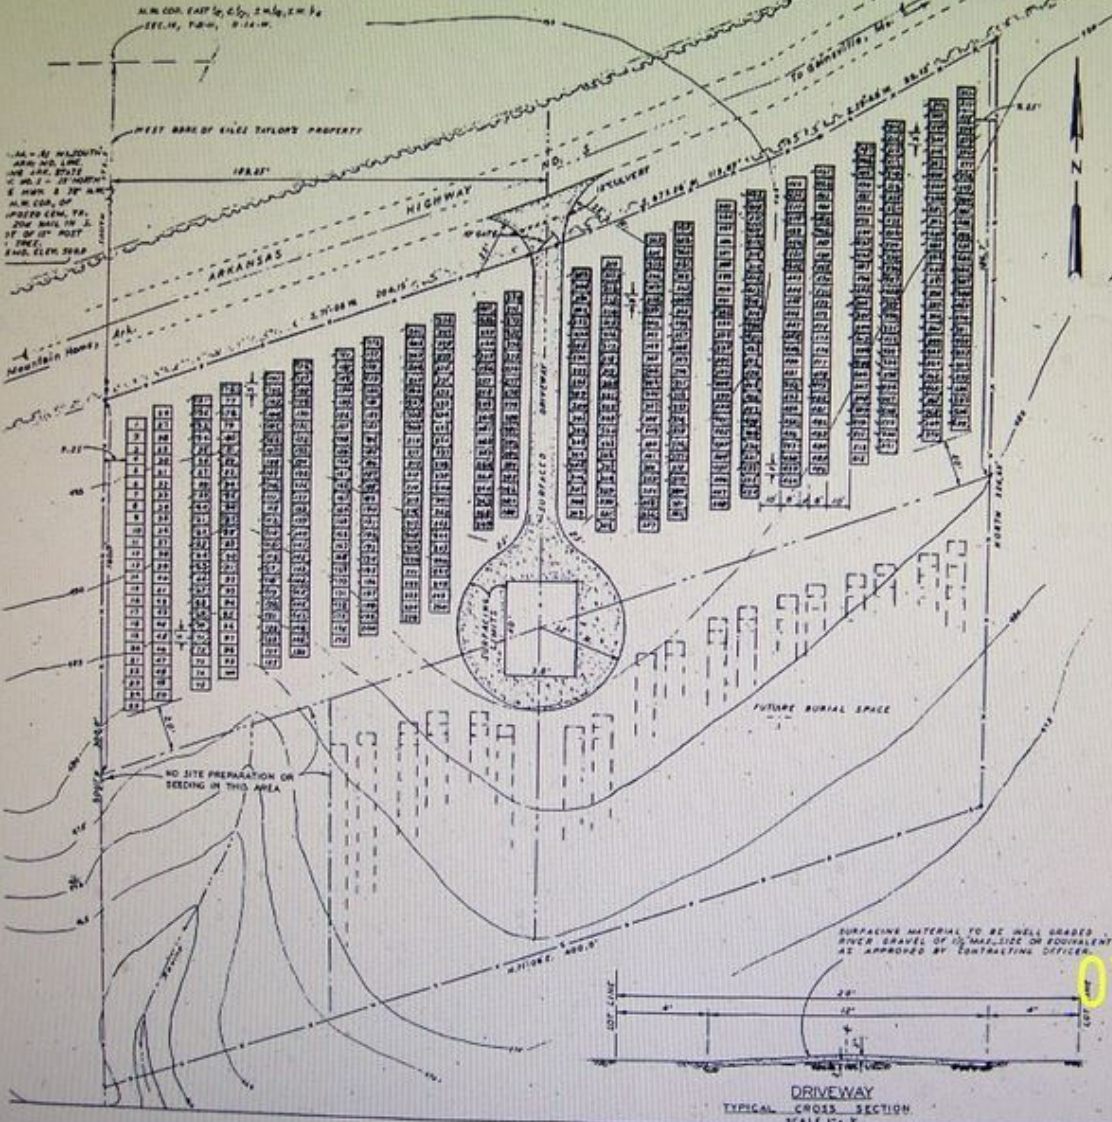

NOTE:
 1. GRAVES SCATTERED OVER ENTIRE AREA.
 2. DASHED OUTLINES INDICATE TENTATIVE LAYOUT OF LOTS IN FUTURE BURIAL AREA.
 3. SEE SHEETS NOS. 2, 3 & 4 FOR SCHEDULES OF RELOCATION.
 4. SEE SHEETS NOS. 10 AND 11 FOR DETAIL OF ROSES, MARKERS AND FENCE.
 5. LOOSE ROCK TO BE REMOVED FROM BURIAL AREAS AND DISPOSED OF IN HEAD OF RAVINE.

LEGEND:
 [Symbol] GRAVES MOVED FROM OTHER CEMETERIES UNDER THIS CONTRACT.
 [Symbol] LOTS RESERVED BY RELATIVES FOR FUTURE BURIAL.
 [Symbol] LOTS FOR FUTURE BURIAL (NOT RESERVED).

RECORD DRAWING AS CONSTRUCTED
 1-18-50
 WHITE RIVER WATERSHED, WHITE RIVER, ARKANSAS
 DISTRICT NO. 15, 1-3-1
 NEW OAKLAND CEMETERY
 IN 11 SHEETS SCALE 1" = 200' SHEET NO. 7
 SCALE OF FEET
 LITTLE ROCK DIST. LITTLE ROCK, ARK. JAN. 1949
 SUBMITTED: [Signature]
 APPROVAL: [Signature]
 HEAD, REG. SEC. CHIEF, ENG. DIV. DISTRICT ENGINEER
 DRAWN A.M.A. SERIAL 1843
 TRACED FILE 133/184
 CHECKED O.L.A.

07/21/2011