



STATE HIGHWAY NO. 14

500' TO LOWRY, ARK.

Cultivated field

ELEV. 660

14" Cedar

300' to Highway No. 14

150' to Bear Creek


Cultivated field

NOTES:

GRAVES IN THIS CEMETERY TO BE RELOCATED IN ADDITION TO MILUM CEM BSC-8-R. SEE SHEET 13 FOR LAYOUT.

RECORD DRAWING AS CONSTRUCTED

WHITE RIVER WATERSHED WHITE RIVER, ARKANSAS
 BULL SHOALS RESERVOIR
 CEMETERY RELOCATION
 GLOVER CEMETERY B.S.-63
 IN 18 SHEETS SCALE: 1:240 SHEET NO. 11
 20 0 20 40 60
 SCALE OF FEET
 LITTLE ROCK DIST., LITTLE ROCK, ARK., MAR. 1948
 SUBMITTED: APPROVAL REC'D: APPROVED:
 John W. Mottel B. Schneider J. A. Kane
 LEAD, RELOC. SEC CHIEF, ENGRG. DIV. COL., CORPS ENGRS.
 DISTRICT ENGINEER
 DRAWN A.M.H. SERIAL 5928
 TRACED CHECKED O.L.G. FILE 139 / 1681

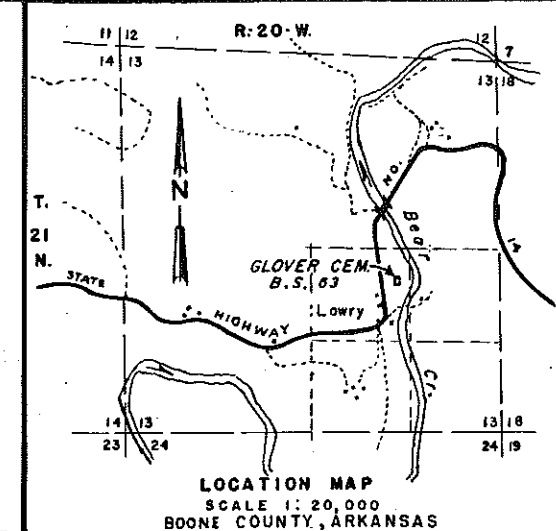

SCHEDULE OF RELOCATION

GRAVE NO.	EXISTING CEMETERY	RELOC. CEM. B.S.C-8-R.		
		TIER NO.	BLOCK NO.	LOT NO.
1	MARTHA GLOVER	17	11	10
2	COLUMBUS GLOVER	17	11	8