


CEM. ELEK 830.

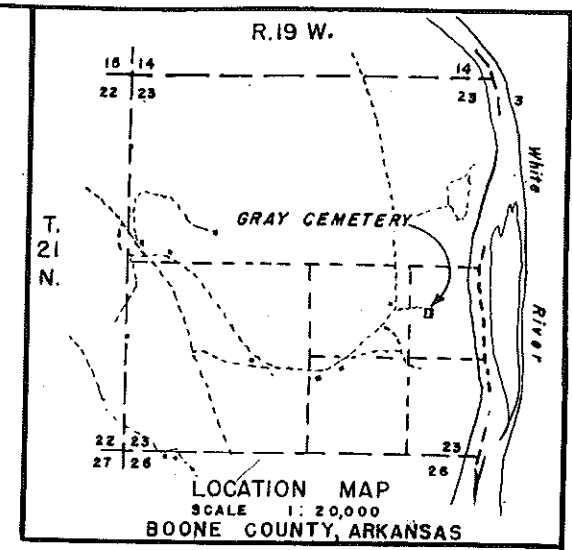

- NOTES:
- GRAVES IN THIS CEMETERY TO BE RELOCATED IN NEW CEDAR CREEK CEMETERY, BSG-12-R. SEE SHEET 11 FOR LAYOUT.
 - SEE SHEET 3 FOR SCHEDULE OF RELOCATION.

RECORD DRAWING AS CONSTRUCTED
[Signature] 1-1-51

WHITE RIVER WATERSHED WHITE RIVER, ARKANSAS
 BULL SHOALS RESERVOIR
 CEMETERY RELOCATION
 GRAY CEMETERY B. S-53

IN 13 SHEETS SCALE: 1:240 SHEET NO. 2
 20 0 20 40 60

SCALE OF FEET

LITTLE ROCK DIST, LITTLE ROCK, ARK., MAR. 1948
 SUBMITTED: APPROVAL REC'D: APPROVED:
[Signature] *[Signature]* *[Signature]*
 HEAD, RELOC. SEC. CHIEF, ENGRG. DIV. LT. COL., CORPS ENGRS.
 ACT. DISTRICT ENGR.

DRAWN: A. M. H. SERIAL: 5983
 TRACED: CHECKED: O. L. G. FILE 139/1852