


SCHEDULE OF RELOCATION			
EXISTING CEMETERY		RELOCATED CEMETERY	
GRAVE NO.		CEM. NO.	GRAVE NO.
1	INFANT OF VAN BILLINGS	B.S.G.-S-R	108
2	INFANT OF JOHN HAMPTON	"	109

- NOTE:
- GRAVES IN THIS CEMETERY TO BE RELOCATED IN MIDWAY CEMETERY B.S.C.-S-R. SCHEDULE OF RELOCATION ON THIS SHEET. SEE SHEET 6 FOR LAYOUT.
 - TRANSPORT REMAINS BY BOAT ACROSS WHITE RIVER DIRECTLY OPPOSITE BILLINGS CEMETERY TO REACH REINTERMENT CEMETERY BY NEAREST ROUTE.
 - VEHICLE ACCESS TO CEMETERY VIA DUGGINSVILLE, MO.

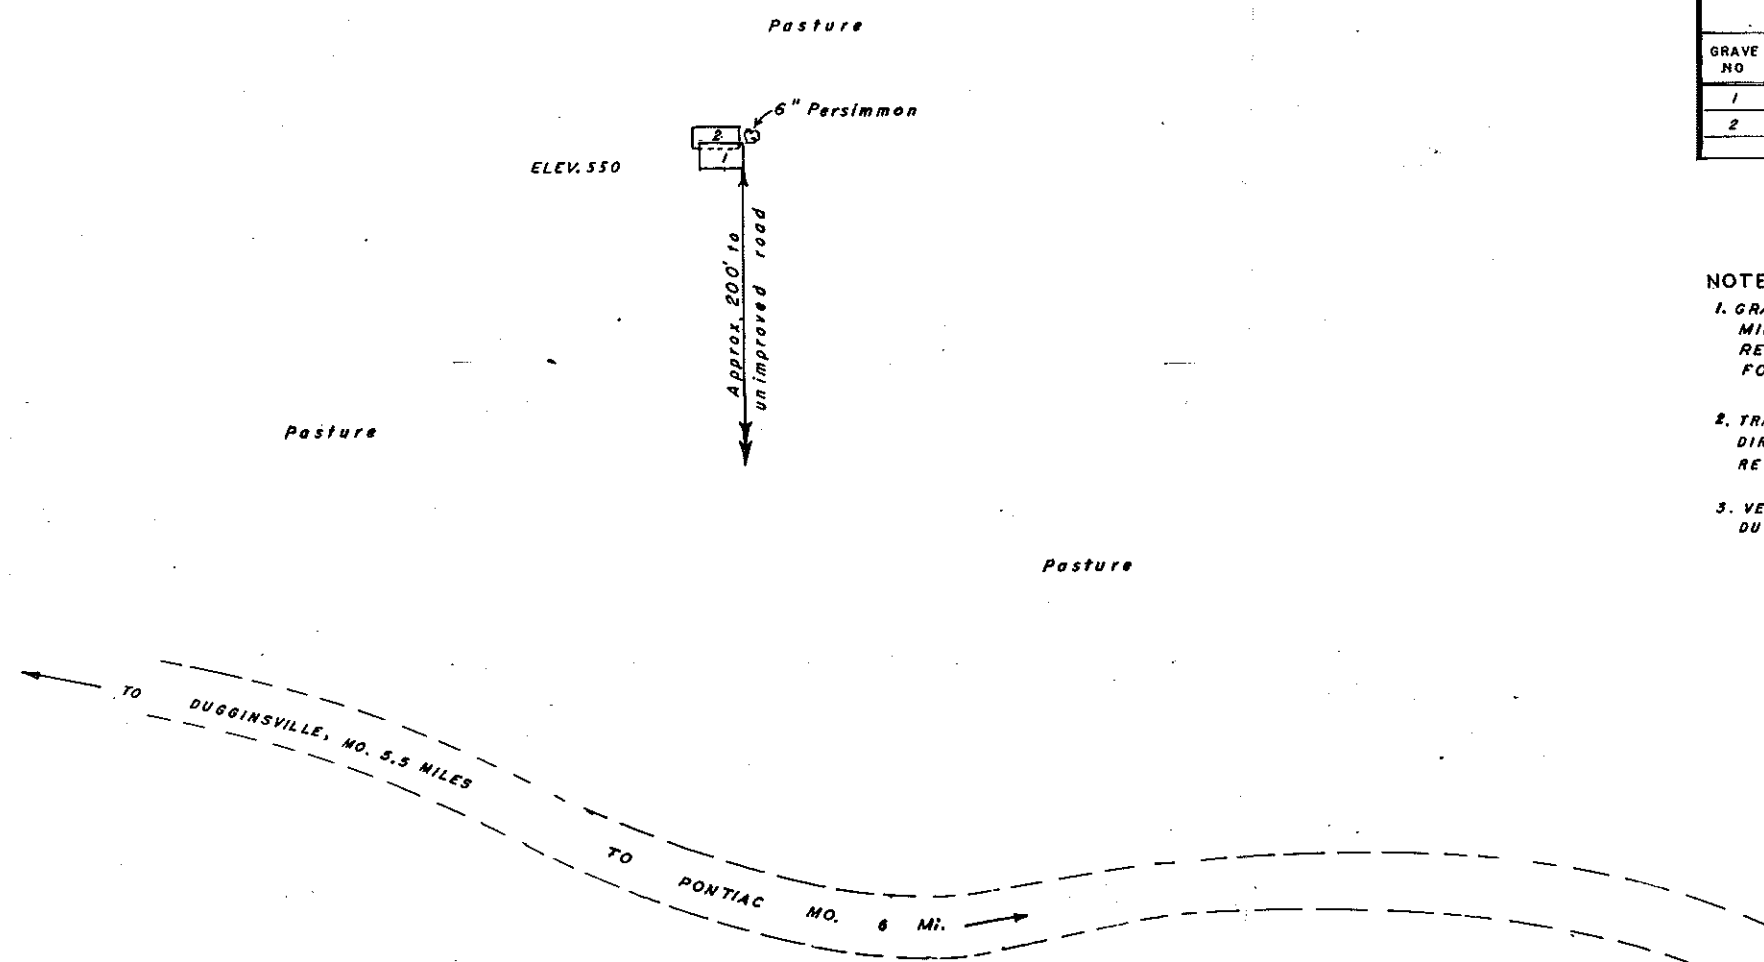

RECORD DRAWING AS CONSTRUCTED
John H. ... 2-22-50

WHITE RIVER WATERSHED WHITE RIVER, ARKANSAS
BULL SHOALS RESERVOIR
CEMETERY RELOCATION
BILLINGS CEMETERY NO. B. S:32

IN 8 SHEETS SCALE: 1:240 SHEET NO. 5
20 0 20 40 60

SCALE OF FEET

LITTLE ROCK DIST., LITTLE ROCK, ARK., MAR. 1948
SUBMITTED: APPROVAL RECD.: APPROVED:
John H. ... *O.P. Schneider* *J. ...*
HEAD, RELOC. SEC. CHIEF, ENGRG. DIV. COL. CORPS ENGRS.
DISTRICT ENGINEER

DRAWN A.M.H. SERIAL 5964
TRACED CHECKED O.L.G. FILE 139/1825