


0.3 Mi. to Ark. Highway No. 14

Open Meadow

10" Hackberry
12" Cherry
18" Wild Cherry
8" Wild Cherry

Cultivated Field

ELEV. 670.

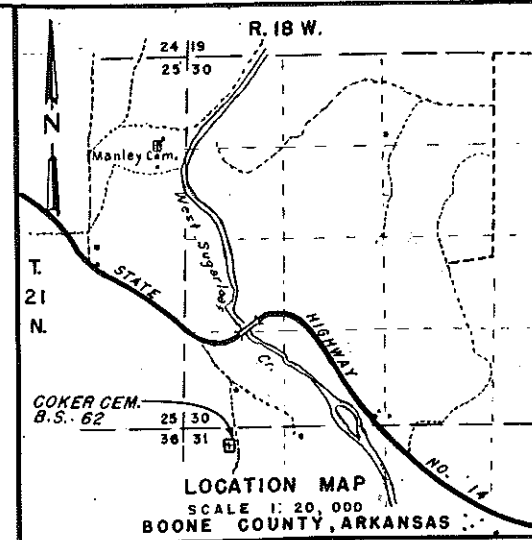

SCHEDULE OF RELOCATION

GRAVE NO.	EXISTING CEMETERY NAME	RELO. CEM. B.S.C.-B.R.		
		TIER NO.	BLOCK NO.	LOT NO.
1	COKER	17	11	9
2	COKER	17	11	7
3	COKER	17	11	5
4	MRS. ASA RUSSELL	17	11	3
5	ASA RUSSELL	17	11	1
6	COKER	17	11	2
7	COKER	17	11	4
8	COKER	17	11	6

NOTES:

GRAVES IN THIS CEMETERY TO BE RELOCATED IN ADDITION TO MILUM CEM. B.S.C.-B.R. SEE SHEET 13 FOR LAYOUT.

RECORD DRAWING AS CONSTRUCTED

John M. Smith 3-7-51

WHITE RIVER WATERSHED WHITE RIVER, ARKANSAS
 BULL SHOALS RESERVOIR
 CEMETERY RELOCATION
 COKER CEMETERY B.S.-62
 IN 18 SHEETS SCALE: 1:240 SHEET NO. 10
 20 0 20 40 60
 SCALE OF FEET
 LITTLE ROCK DIST., LITTLE ROCK, ARK., MAR. 1948
 SUBMITTED: APPROVAL, RECD. APPROVED:
John M. Smith *J.R. Schneider* *J. H. Lane*
 HEAD, RELOC. SEC. CHIEF, ENGRG. DIV. COL., CORPS ENGRS.
 DISTRICT ENGINEER
 DRAWN A.N.H. SERIAL 5926
 TRACED
 CHECKED G.L.G. FILE 139/1880