



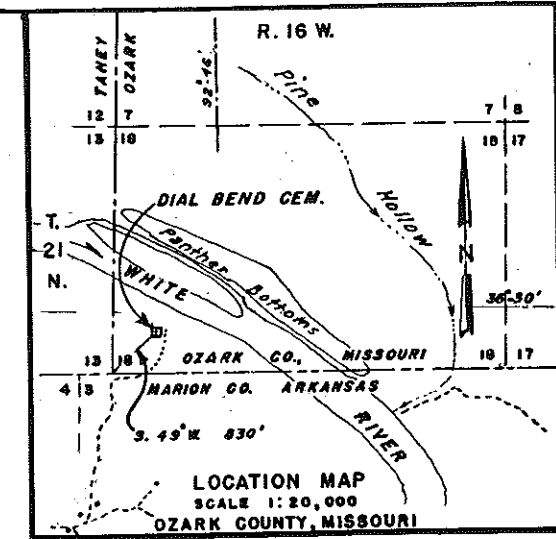

Pasture

Pasture

TO PEEL, ARK. APPROX. 5.7 MI.

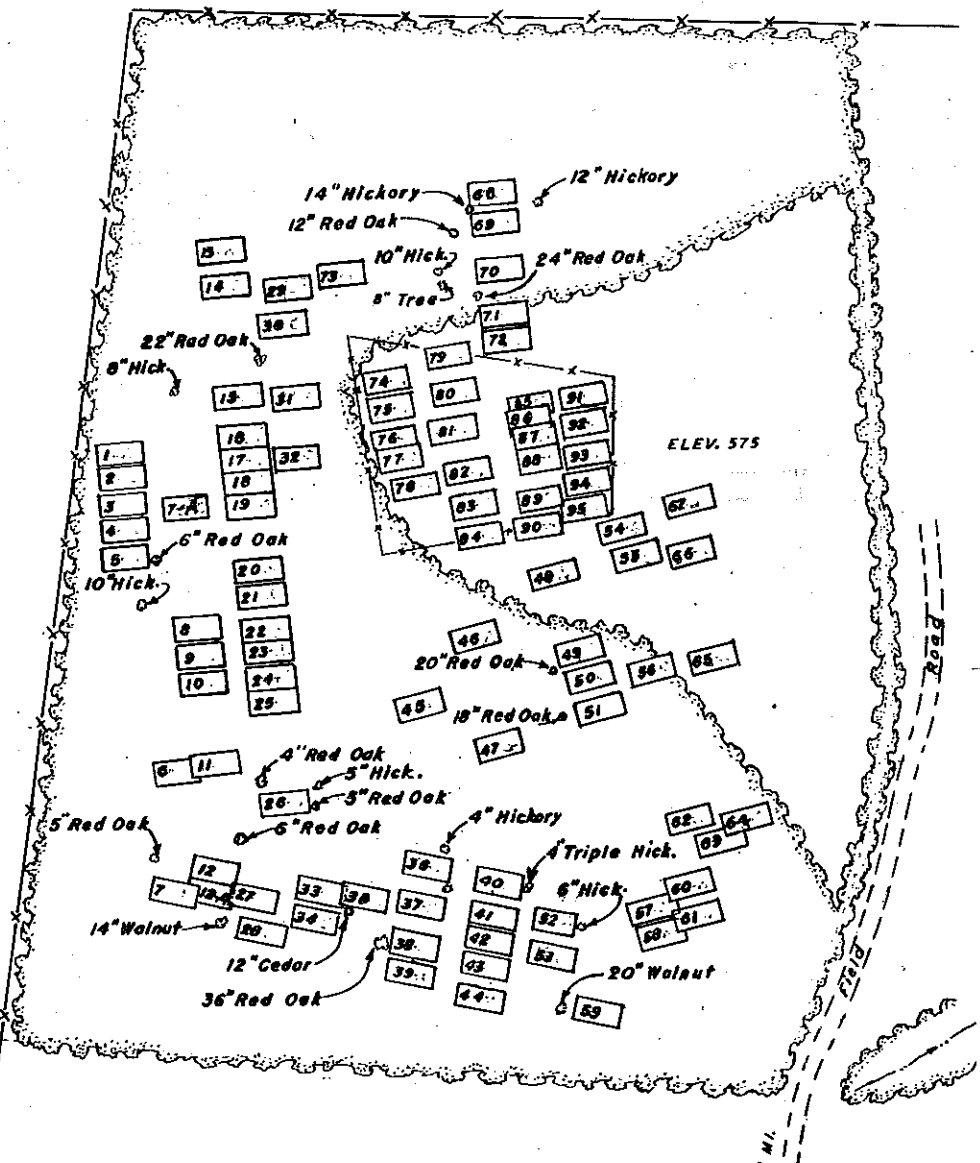

NOTES:

- 1. GRAVES IN THIS CEMETERY TO BE RELOCATED IN NEW PEEL CEMETERY B.S.C.-6-R. SEE SHEET 13 FOR LAYOUT.
- 2. SEE SHEET 7 FOR SCHEDULE OF RELOCATION.
- 3. ACCESS THROUGH FARMYARD OF A.C. BROWN FARM. SEE SHEET 2 FOR ROUTE TO REINTERMENT CEMETERY.

RECORD DRAWING AS CONSTRUCTED
[Signature] 6-15-50

WHITE RIVER WATERSHED WHITE RIVER, ARKANSAS
BULL SHOALS RESERVOIR
CEMETERY RELOCATION
DIAL BEND CEMETERY NO. BS-15

IN 16 SHEETS SCALE: 1:240 SHEET NO. 6
20 0 20 40 60

SCALE OF FEET

LITTLE ROCK DIST., LITTLE ROCK, ARK., MAR. 1948
SUBMITTED: APPROVAL RECD: APPROVED:
[Signature] *[Signature]*
HEAD, RELOC. SEC. CHIEF, ENGRG. DIV. COL., CORPS ENGRS.
DISTRICT ENGINEER
DRAWN A.M.H. SERIAL 5900
CHECKED O.L.G. FILE 139/1646