
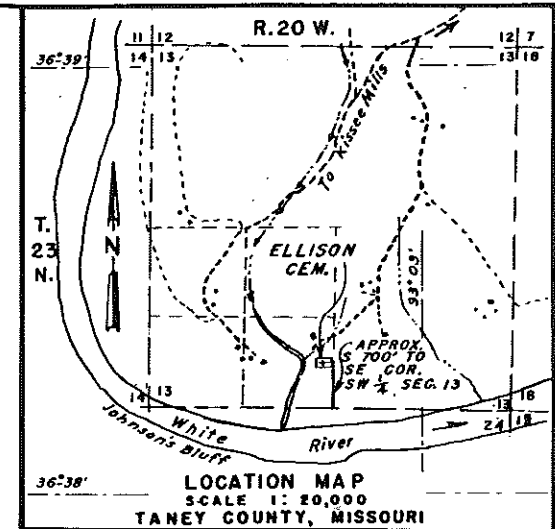


250' to graded road
vehicles can drive to cemetery

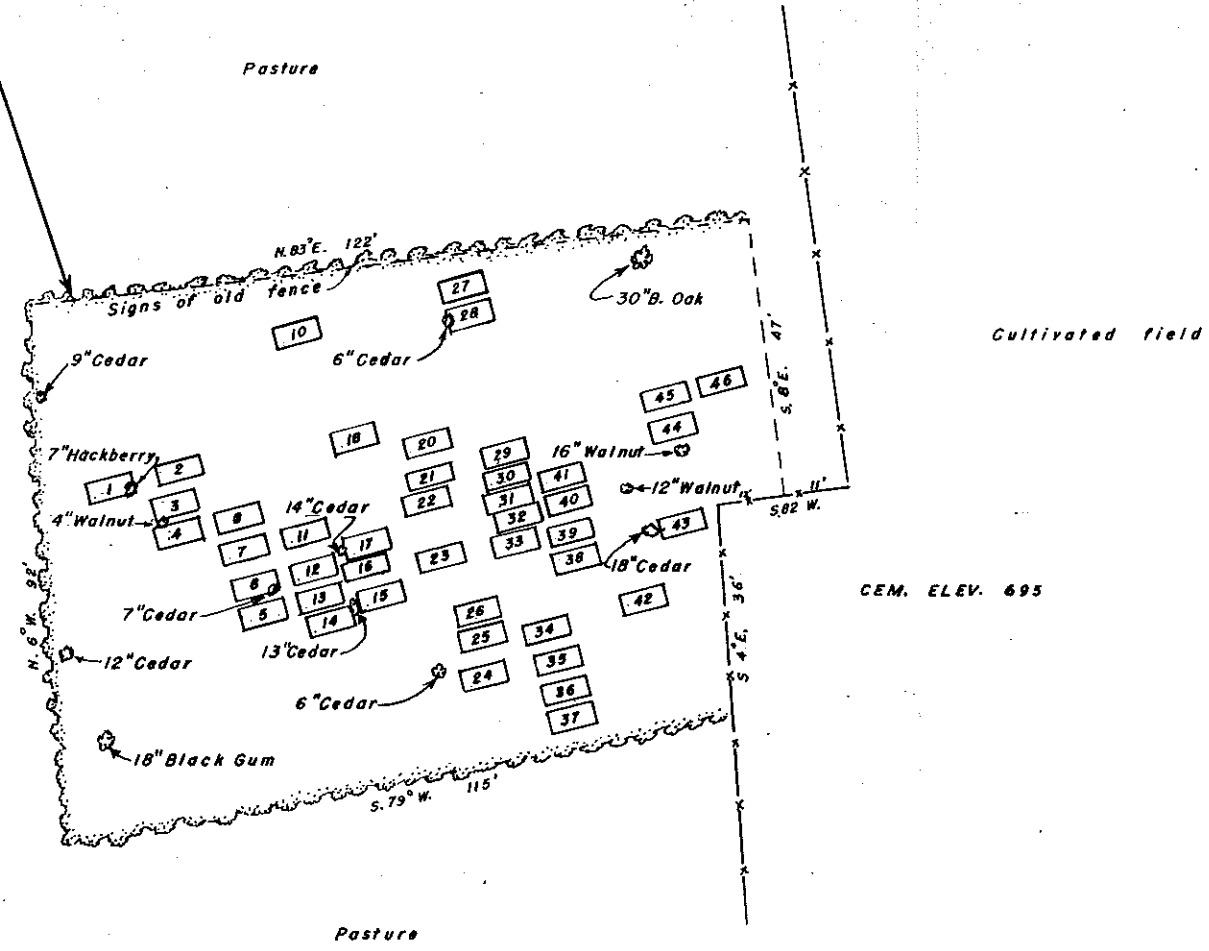

NOTE:
 1. GRAVES IN THIS CEMETERY TO BE RELOCATED IN NEW KISSEE MILLS CEMETERY BSC-14-R. SEE SHEET 9 FOR LAYOUT AND SHEET 7 FOR SCHEDULE OF RELOCATION.

RECORD DRAWING AS CONSTRUCTED
John Sample 7-10-51

WHITE RIVER WATERSHED WHITE RIVER, ARKANSAS
 BULL SHOALS RESERVOIR
 CEMETERY RELOCATION
 ELLISON CEMETERY B.S.-52

IN 11 SHEETS SCALE: 1:240 SHEET NO. 6
 20 0 20 40 60
 SCALE OF FEET

LITTLE ROCK DIST., LITTLE ROCK, ARK., SEPT. 1950
 SUBMITTED: APPROVAL REC'D: APPROVED:
W.R. Clark *S.L. Schwab* *Harold Johnson*
 HEAD, DESIGN BR. CHIEF, ENGRS. DIV. COL., CORPS ENGRS. DISTRICT ENGR.
 DRAWN: A.M.H. SERIAL 6059
 TRACED FILE 139/1896
 CHECKED M.R.B.